* ..... DENOTE FUTURE EXTENSION

** .... DENOTE SUPPLY AND INSTALLATION BY PPC

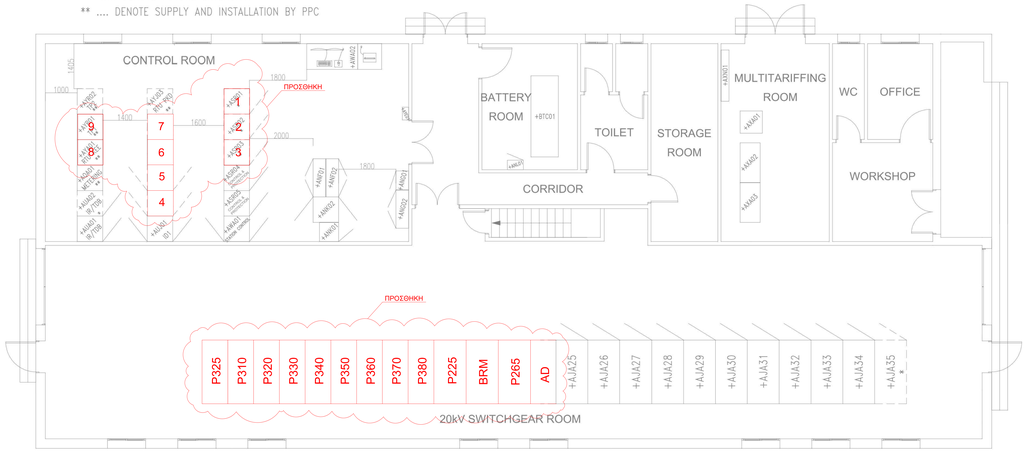

AJA25.....20kV Incomer 3
AJA26.....20kV Line Feeder 19
AJA27.....20kV Line Feeder 20
AJA28.....20kV Line Feeder 21
AJA29.....20kV Line Feeder 22
AJA30.....20kV Line Feeder 23
AJA31.....20kV Line Feeder 24
AJA32.....20kV Line Feeder 25
AJA33.....20kV Line Feeder 26
AJA34.....20kV Capacitor Bank Feeder 3
ANF01.....415/230V AC Distribution Board
ANF02.....415/230V AC Distribution Board
ANG01.....415/230V AC Distribution Board - Building Service 1
ANG02.....415/230V AC Distribution Board - Building Service 2
ANK01.....110V DC Battery Charger Board
ANK02.....110V DC Distribution Board
ANL01.....110V DC Battery Fuse Box
AQA01.....Metering Panel
ASR04.....150kV Line Feeder Larissa II - Control & Protection Panel
ASR05.....150kV Transformer Feeder 3 - Control & Protection Panel
AUA01.....IR Panel 1AUJ01.....ID Panel 1
AWA01.....Station Control Panel
AWA02.....Human Machine Interface (HMI)
AXA01.....Generator Cabinet System 1
AXA02.....Capacitors Cabinet System 1
AXA03.....Reactors Cabinet System 1
AXN01.....415/230V AC Distribution Board
AYA01.....RTU Panel 1
AYA02.....RTU Panel 2
AYE01.....Fire Detection System Panel
AYJ01.....RTU Panel
AYJ02.....Relais Panel
AYR01.....Teleprotection and PLC Panel
AYR02.....Teleprotection Panel
BTC01.....110V DC Battery

1. ΠΙΝΑΚΑΣ ΕΛΕΓΧΟΥ ΚΑΙ ΠΡΟΣΤΑΣΙΑΣ Μ/Σ No2 (ΔΕΔΔΗΕ)
2. ΠΙΝΑΚΑΣ ΕΛΕΓΧΟΥ Μ/Σ No2, No3 (ΑΔΜΗΕ)
3. ΠΙΝΑΚΑΣ ΕΛΕΓΧΟΥ ΚΑΙ ΠΡΟΣΤΑΣΙΑΣ ΠΥΛΗΣ P10 (ΑΔΜΗΕ-ΜΕΛΛΟΝΤΙΚΟΣ)
4. ΠΙΝΑΚΑΣ ΓΕΝΙΚΩΝ ΣΗΜΑΝΣΕΩΝ (ΑΔΜΗΕ)
5. UPS ΓΙΑ ΨΣΕ (ΑΔΜΗΕ)
6. ΠΙΝΑΚΑΣ ΨΣΕ (ΑΔΜΗΕ) - SCADA & ETHERNET SWITCHES
7. ΠΙΝΑΚΑΣ ΔΙΕΠΑΦΗΣ ΜΕ ΚΕΕ (RTU ΑΔΜΗΕ)
8. ΠΙΝΑΚΑΣ ΨΣΕ ΔΕΔΔΗΕ & ΜΟΝΑΔΩΝ ΕΠΙΚΟΙΝΩΝΙΑΣ (SCADA & GATEWAYS)
9. ΠΙΝΑΚΑΣ ΓΕΝΙΚΩΝ ΣΗΜΑΤΩΝ & UPS ΓΙΑ ΨΣΕ ΔΕΔΔΗΕ

This drawing is the PROPERTY of
VA TECH T&D GmbH
A-1101 VIENNA AUSTRIA
NOTE PROTECTION DIN 34 I

0	AS BUILT	2007/01/19	HI	HI	AE-PA4
Mod.	Modification	Date	Drawn	Checked	Approved

PPC Drawing Nr.: FF-10834-124

Purchaser: PUBLIC POWER CORPORATION S.A.	Proj. Nr: C243 35 025
Plant: LARISSA – AGIA SUBSTATION	Contract Nr: =AEA00
Title: ARRANGEMENT DRAWING CONTROL BUILDING GROUND FLOOR	+AEA00
	Customer Nr: DYPM – 99204
Drawn: 2007/01/19 HI	Scale 1:50
Checked: 2007/01/19 HI	ISO / B 128 EUROPA
Approved: AE-PA4	Note Protection DIN 34 I
	Fields: 07/01/19 Filename: PDM
VA TECH T&D GmbH	Drawing Nr: 35025-2014 Rev. 0
	Sheet: 1 of 1 A1